


TENNESSEE DEPARTMENT OF HEALTH AND ENVIRONMENT
CERTIFICATE OF COMPLETION OF SUBSURFACE SEWAGE DISPOSAL SYSTEM

Owner, Developer, Contractor, Installer, Etc.
Dianne Reeves
Location 2917 Luke Moser Rd.
≈ 1m N. of Hwy 50E on Left

Type of System: () 1. Standard () 5. Mound
() 2. Alternating () 6. Lagoon
() 3. Chapter () 7. Large Diameter Gravelless Pipe
() 4. Low Pressure Pipe 8. Other 68-13403(i)
Megler 1000 gal Septic Tank
(type) (volume)
Estimated Absorption Rate 75
(minutes per inch)
 New Installation () Repair
Installed by: Stan Mann

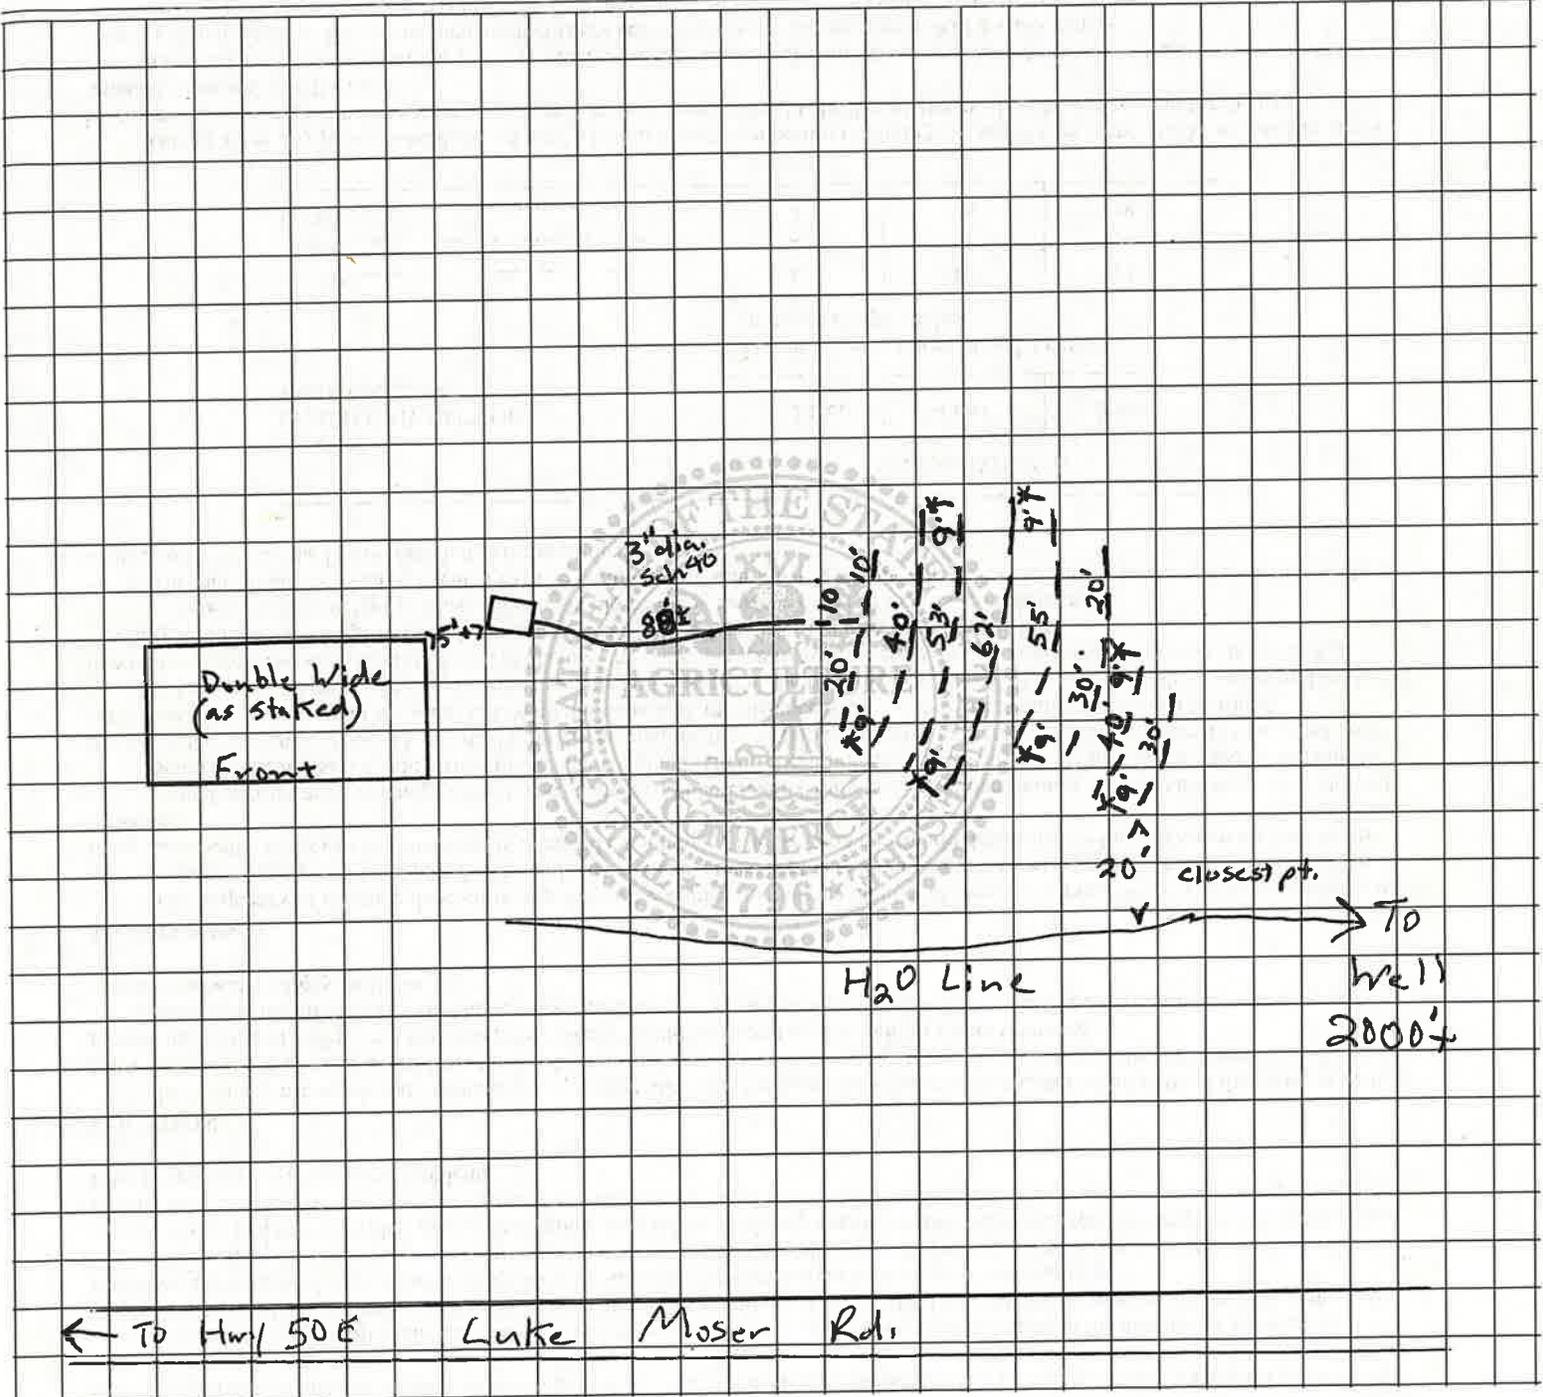

Construction Approved By: Jeff C. Coggan R.P.E. 28 Jul 92
(Name and Title) (date)

TENNESSEE DEPARTMENT OF HEALTH AND ENVIRONMENT PERMIT FOR CONSTRUCTION OF SUBSURFACE SEWAGE DISPOSAL SYSTEM

DIANNE REEVES
Owner, Developer, Contractor, Installer, Etc.
Location: **2917 LAKE MOSER RD**

- Evaluation Based Upon:
- 1. Soil typing by Soil Scientist
 - 2. Soil Percolation Test
 - 3. Environmental Specialist

- Permit Requirements Based Upon:
- Soil Texture/Structure
 - Soil Depth
 - Soil Drainage
 - Presence of Restrictive Layers
 - Position

Estimated Absorption Rate: **75**
Minutes per inch

- Conventional Systems:
Type of System: 1. Standard
 2. Alternating
 3. Chapter
 4. Other **TALB-13-903 (i)**

- Alternative Systems:
- 1. Low Pressure Pipe
 - 2. Mound
 - 3. Lagoon
 - 4. Large diameter graveless pipe
 - 5. Other

See attached design package

- Also required:
- 1. Curtain Drain
 - 2. Flow Diversion Valve
 - 3. Sewage Pump
 - 4. Other:

This system shall consist of a two compartment septic tank holding **900 (min)** gallons, with **370** linear feet in **6-7** trenches, **36** inches wide and **22** inches deep.

All installers of subsurface sewage disposal systems must hold a valid annual license from the Tennessee Department of Health and Environment.

The recipient of this permit agrees to construct or have constructed the above described system in accordance with 68-13-401 et. seq. and The Regulations To Govern Subsurface Sewage Disposal Systems. If any part of the system is covered before being inspected and approved, it shall be uncovered by the recipient of the permit at the direction of personnel of the Department of Health and Environment. Any curing, filling or alterations of the soil conditions on the aforementioned property after this day may render this approval null and void.

Roman E. Campbell
(Signature of Recipient)
COLUMBIA

Date **7/22/92**
Tennessee in **MAURY** County



Issued by **Dale Robinson ENV. SPEC. II**
(Name and Title)

Date **22 JULY 92**
(Date of Issue)

This permit is valid for 3 years from date of issue.

(Not to Scale)

Notes:
Shoot grades and adjust fieldlines according to contour of ground.
Keep fieldline at least 10 ft off property lines, waterlines and 50 ft off any wells.

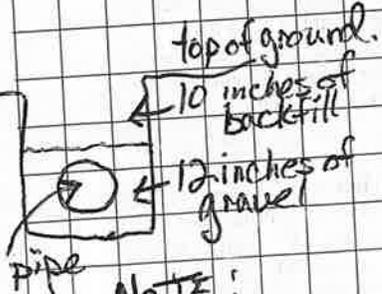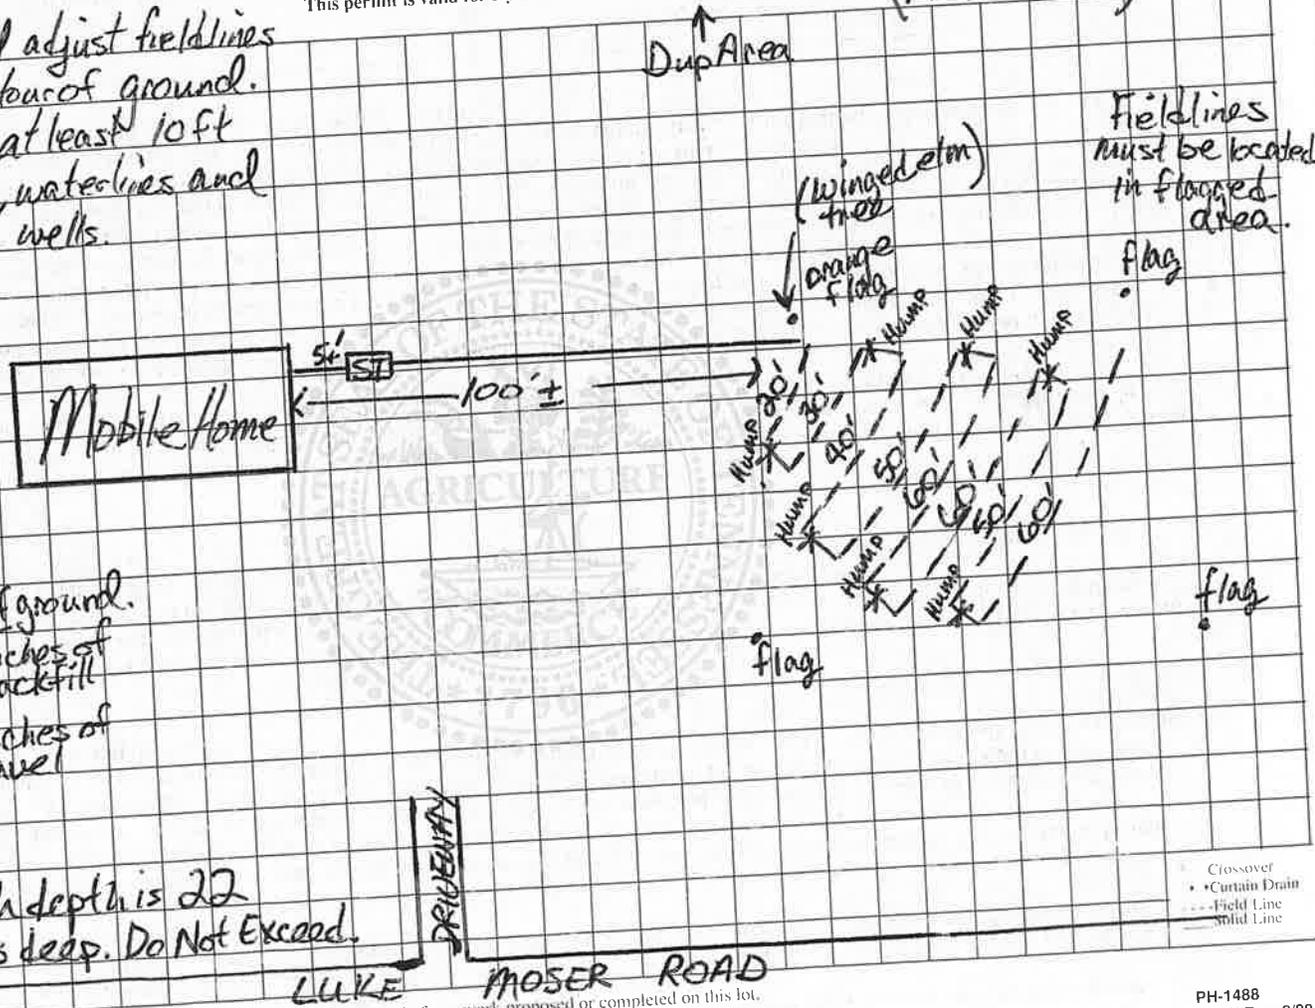

NOTE:
Trench depth is 22 inches deep. Do Not Exceed.

- Crossover
- Curtain Drain
- Field Line
- Solid Line

This is a permit to construct and is not intended to imply approval of any work proposed or completed on this lot.

Original—File
Copy—Owner

Authentisign
Dianne G. Campbell

10/04/25